

PERMIT APPROVAL SPECIFICATIONS

Owner information:

Kreis, Allen

Tammerlane Lot 3, Block 6
23 21N 29W

Name

S T R

P.O. Box 488

March 25, 2005

Mailing address

Date Submitted

Thompson Falls, MT 59873

April 14, 2005

City

Date Approved

05-160

April 14, 2006

Permit Number

Expiration Date

Permit Specifications:

This permit is approved with the following specifications:

1000 Gallon Septic Tank

_____ size of septic tank

375

_____ lineal feet of drainfield

(750 square feet of drainfield)



Yes _____ Any special design for the system. List design specifications:

Install a Standard Absorption Trench System. Remember to keep the trenches no deeper than 36 inches. Install laterals in 4 trenches, each trench 95 feet in length and 2 feet wide. Please follow all county wastewater regulations & the state regulations as outlined in Circular DEQ 4 2004 edition. Install the system exactly as per approved lot layout. Pre-notification is mandatory before backfilling system.

Initials of Sanitarian

Sanders County Sanitarian

**AS-BUILT SKETCH
AND
STATEMENT OF ACCURACY OF INSTALLATION**

Land owner's name Joseph Moyer

Permit number 05-160

I, Gary Campbell, as the licensed installer or landowner for the following system have constructed or altered the septic system on the parcel referenced by the permit number above.

I do hereby declare that the EXACT specifications of the approved permit have been followed. Accompanying this statement is a copy of the county approved lot layout and my as-built sketch. My as-built sketch is included on another sheet of paper. **I understand that it is my responsibility to submit the above within 10 days of the completion of the system.**

Installer's Signature Gary L Campbell

Installer's License Number LI - TF03

Completion Date of System 29 August 2005

.....
Checklist of as-built sketch:


- North Arrow
- Triangular measurements from two corners of house to tank access lid
- Measurement of pipe from tank to D-box or manifold
- All parcel boundaries**
- Distance between the system and at least two parcel boundaries

Additional information needed (fill the blanks in with quantitative data):

90 length of drainfield laterals
4 number of drainfield laterals
1000 volume of septic tank



240'

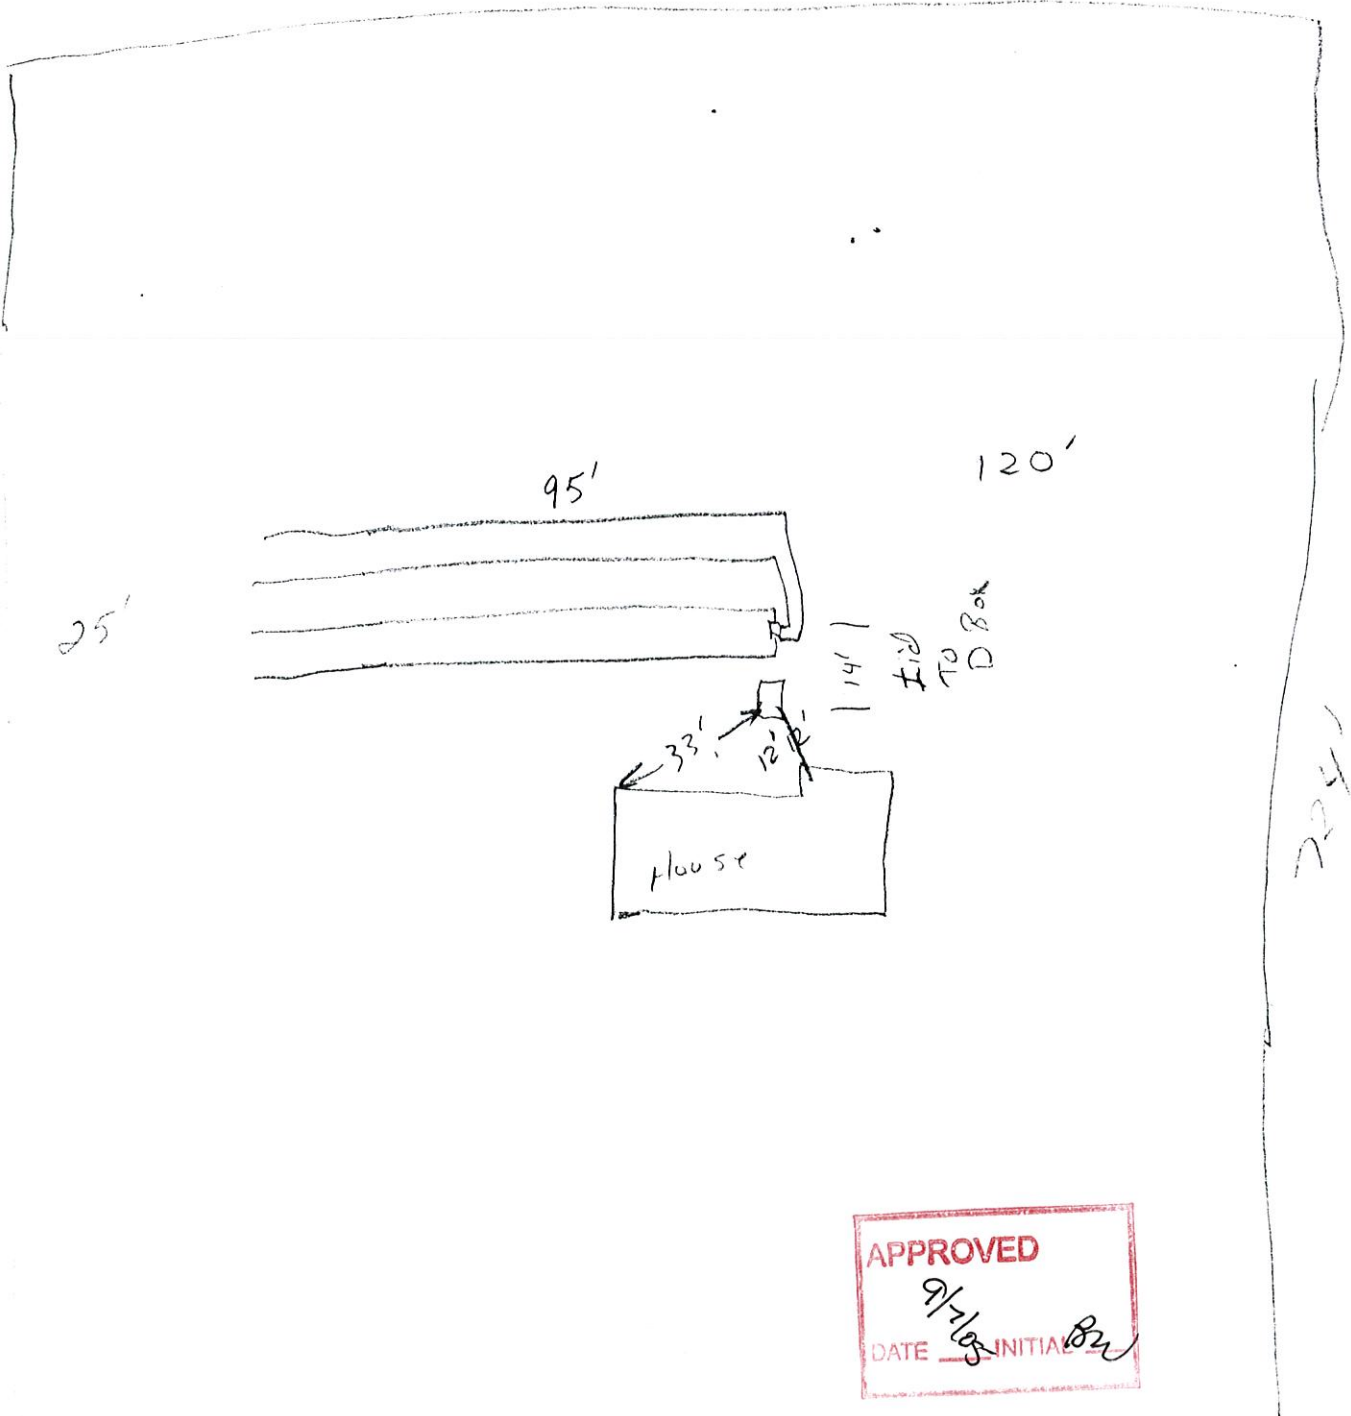

APPROVED
 9/7/05
 DATE _____ INITIAL *BM*

Joe Mayer
 AS Built
 #05-160

